




TOWN OF BECKMAN
DUTCHESS CO., N.Y.
NOVEMBER 13, 2024

**FINAL ROAD ABUTT
FOR
STONE RIDGE ESTATES**

SCALE: 1" = 50'

ROBERT V. OSWALD
LAND SURVEYING
(845) 228-6436 FAX (845) 228-1315
175 WALSH ROAD, LAGRANGEVILLE, NEW YORK 12540

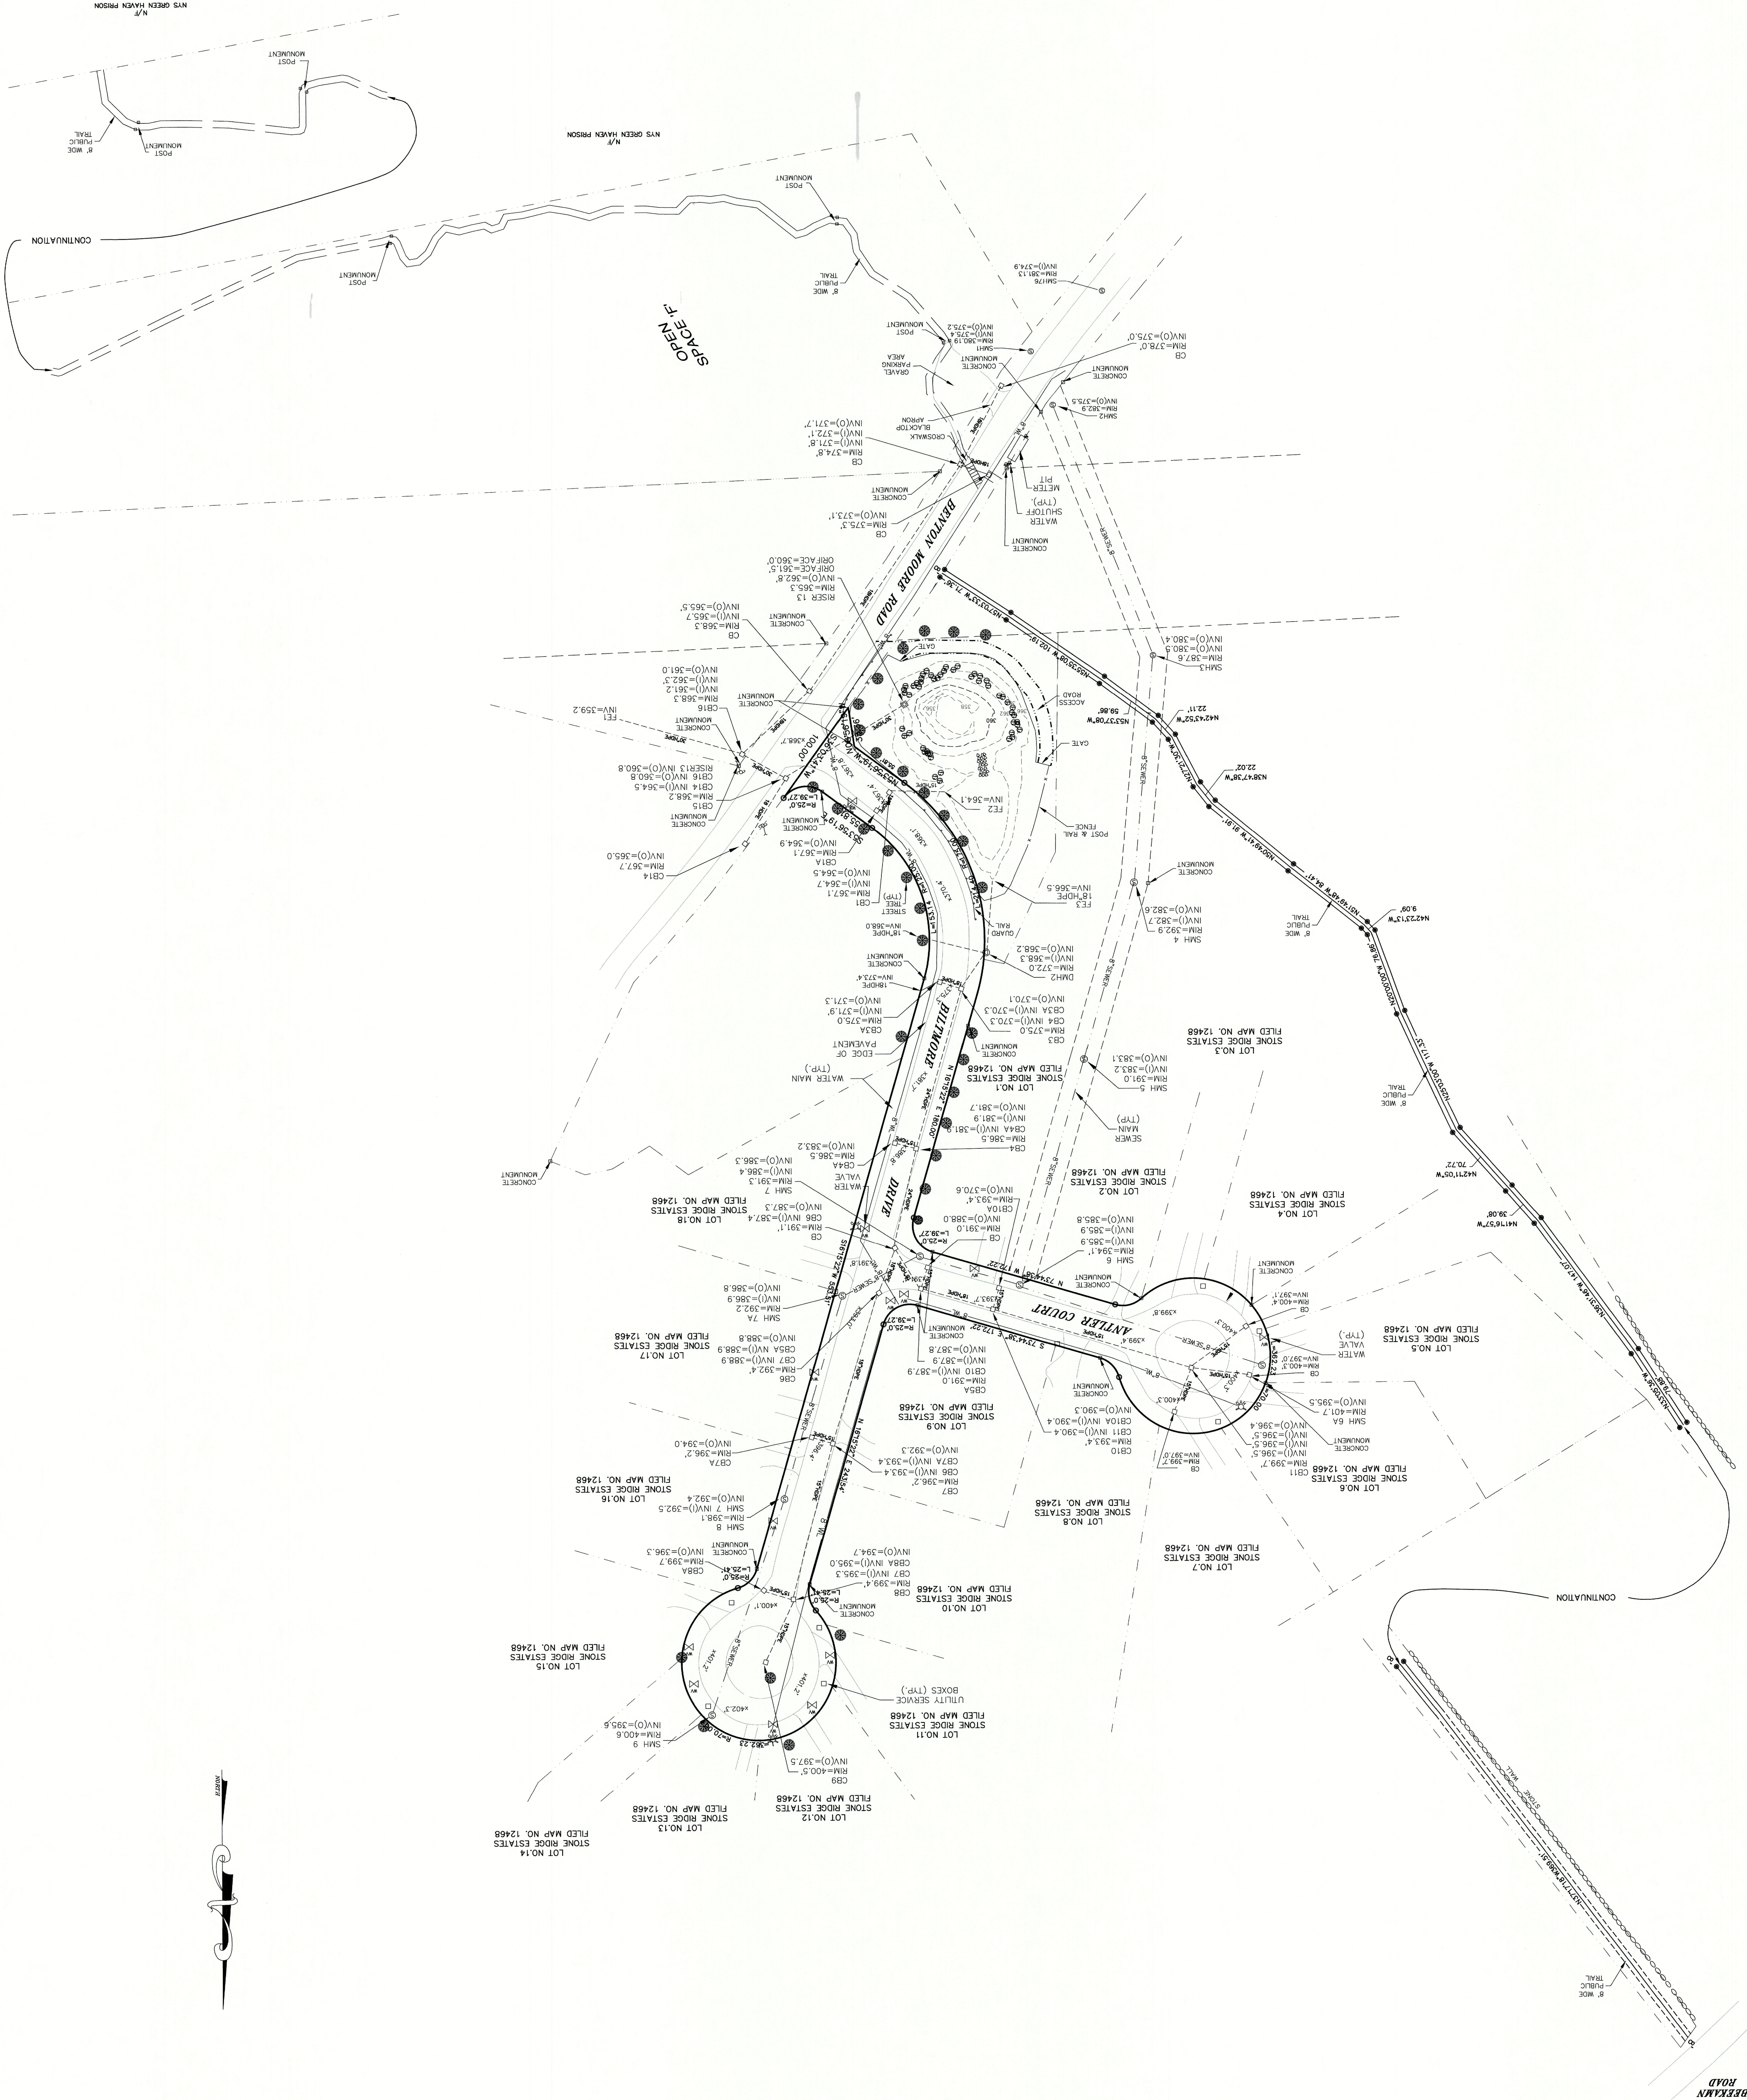

TOWN OF BECKMAN
DUTCHESS CO., N.Y.
NOVEMBER 13, 2024

**FINAL ROAD ABUTT
FOR
STONE RIDGE ESTATES**

SCALE: 1" = 50'

ROBERT V. OSWALD
LAND SURVEYING
(845) 228-6436 FAX (845) 228-1315
175 WALSH ROAD, LAGRANGEVILLE, NEW YORK 12540

