

To:

All Bidders

From:

Michael R. Berta, AIA

Date:

October 10, 2025

Subject:

Addendum No 1

Please take note of the following clarifications or additions to the bid package.

- 1) All patching will be the responsibility of the general contractor, alternate form section 004323 has been updated to include a deduct alternate if contract no 2 for the electrical upgrades bids are not accepted.
- 2) Bollards have been added to the plans to protect the proposed electrical equipment & propane tank.

Drawings Modifications:

B1-090	Building No 1 – Elevations (Detail added)
B1-100	Building No 1 - Floor Plan (bollards added)
B2-090	Building No 2 - Elevations (no changes)
B2-100	Building No 2 - Floor Plan (notes added)

Respectfully Submitted.

Michael R. Berta, AIA

Principal

DOCUMENT 000115 - LIST OF DRAWING SHEETS

PART 1 - GENERAL

1.1 LIST OF DRAWINGS

- A. Drawings: Drawings consist of the Contract Drawings and other drawings listed on the Table of Contents page of the separately bound drawing set titled Proposed Garage Door Replacement for Highway Garage Buildings No 1 & 2 Town of Beekman, dated September 30, 2025, as modified by subsequent Addenda and Contract modifications.
- B. List of Drawings: Drawings consist of the following Contract Drawings and other drawings of type indicated:

Building No 1

B1-090 B1-100	Proposed Elevation and Cross Section Floor Plan
P-001 P-201	Symbol List, Abbreviations, Specifications and Notes Floor Plan, Details and Notes

Building No 2

B2-090	Proposed Elevation and Cross Section
B2-100	Floor Plan

PART 2 - PRODUCTS (Not Used) PART 3 - EXECUTION (Not Used)

END OF DOCUMENT 000115

DOCUMENT 004323 - ALTERNATES FORM

PART 1 - GENERAL

1.1 BID INFORMATIO	IN
--------------------	----

Δ	Bidder:	
Л.	Diddei.	

- B. Project Name: Town of Beekman Highway Garage Building no 1 & 2 Garage Door Replacement, Minor Repair and Electrical Upgrades.
- C. Project Location: 4 Main Street Poughquag, NY 12570.
- D. Owner: Town of Beekman.
- E. Owner Project Number: 2025-0804.
- F. Architect: Michael R. Berta, AIA Architecture & Planning.
- G. Architect Project Number: 2025-016.

1.2 BID FORM SUPPLEMENT

A. This form is required to be attached to the Bid Form.

1.3 DESCRIPTION

- A. The undersigned Bidder proposes the amount below be added to or deducted from the Base Bid if particular alternates are accepted by Owner. Amounts listed for each alternate include costs of related coordination, modification, or adjustment.
 - Cost-Plus-Fee Contract: Alternate price given below includes adjustment to Contractor's Fee.
- B. If the alternate does not affect the Contract Sum, the Bidder shall indicate "NO CHANGE."
- C. If the alternate does not affect the Work of this Contract, the Bidder shall indicate "NOT APPLICABLE."
- D. The Bidder shall be responsible for determining from the Contract Documents the affects of each alternate on the Contract Time and the Contract Sum.


ALTERNATES FORM 004323 - 1


- E. Owner reserves the right to accept or reject any alternate, in any order, and to award or amend the Contract accordingly within [30] days of the Notice of Award unless otherwise indicated in the Contract Documents.
- F. Acceptance or non-acceptance of any alternates by the Owner shall have no effect on the Contract Time unless the "Schedule of Alternates" Article below provides a formatted space for the adjustment of the Contract Time.


1.4		SCH	IFD	l II F	=	FΔ	I TF	RN	JΔ	TE	: 5
1.4	,	OOL	படப	いしし	_ ()	_		1 🗸 1	v /-	\ I L	


A.		quired electrical work for dedicated outlets and electric ct no 2 is accepted for Buildings No 1 & 2	
	DEDUCT:	Dollars (\$	_).
	ADD DEDUCT alternate.	calendar days to adjust the Contract Time for this	
B.	Alternate No. 2: Cost of requestract no 2 is accepted for	uired patch & repair work required for gypsum board i r Buildings No 1 & 2	if
	DEDUCT:	Dollars (\$	_).
	ADD DEDUCT alternate.	calendar days to adjust the Contract Time for this	
C.	SUBMISSION OF BID SUP	PLEMENT	
D.	Respectfully submitted this	day of, 2025.	
E.	Submitted By:or corporation).	(Insert name of bidding	g firm
F.	Authorized Signature:signature).	(Handwritten	
G.	Signed By: name).	(Type or pri	nt
H.	Title: President).	(Owner/Partner/President/Vice	
	2 - PRODUCTS (Not Used) 3 - EXECUTION (Not Used)		
END O	F DOCUMENT 004323		

ALTERNATES FORM 004323 - 2

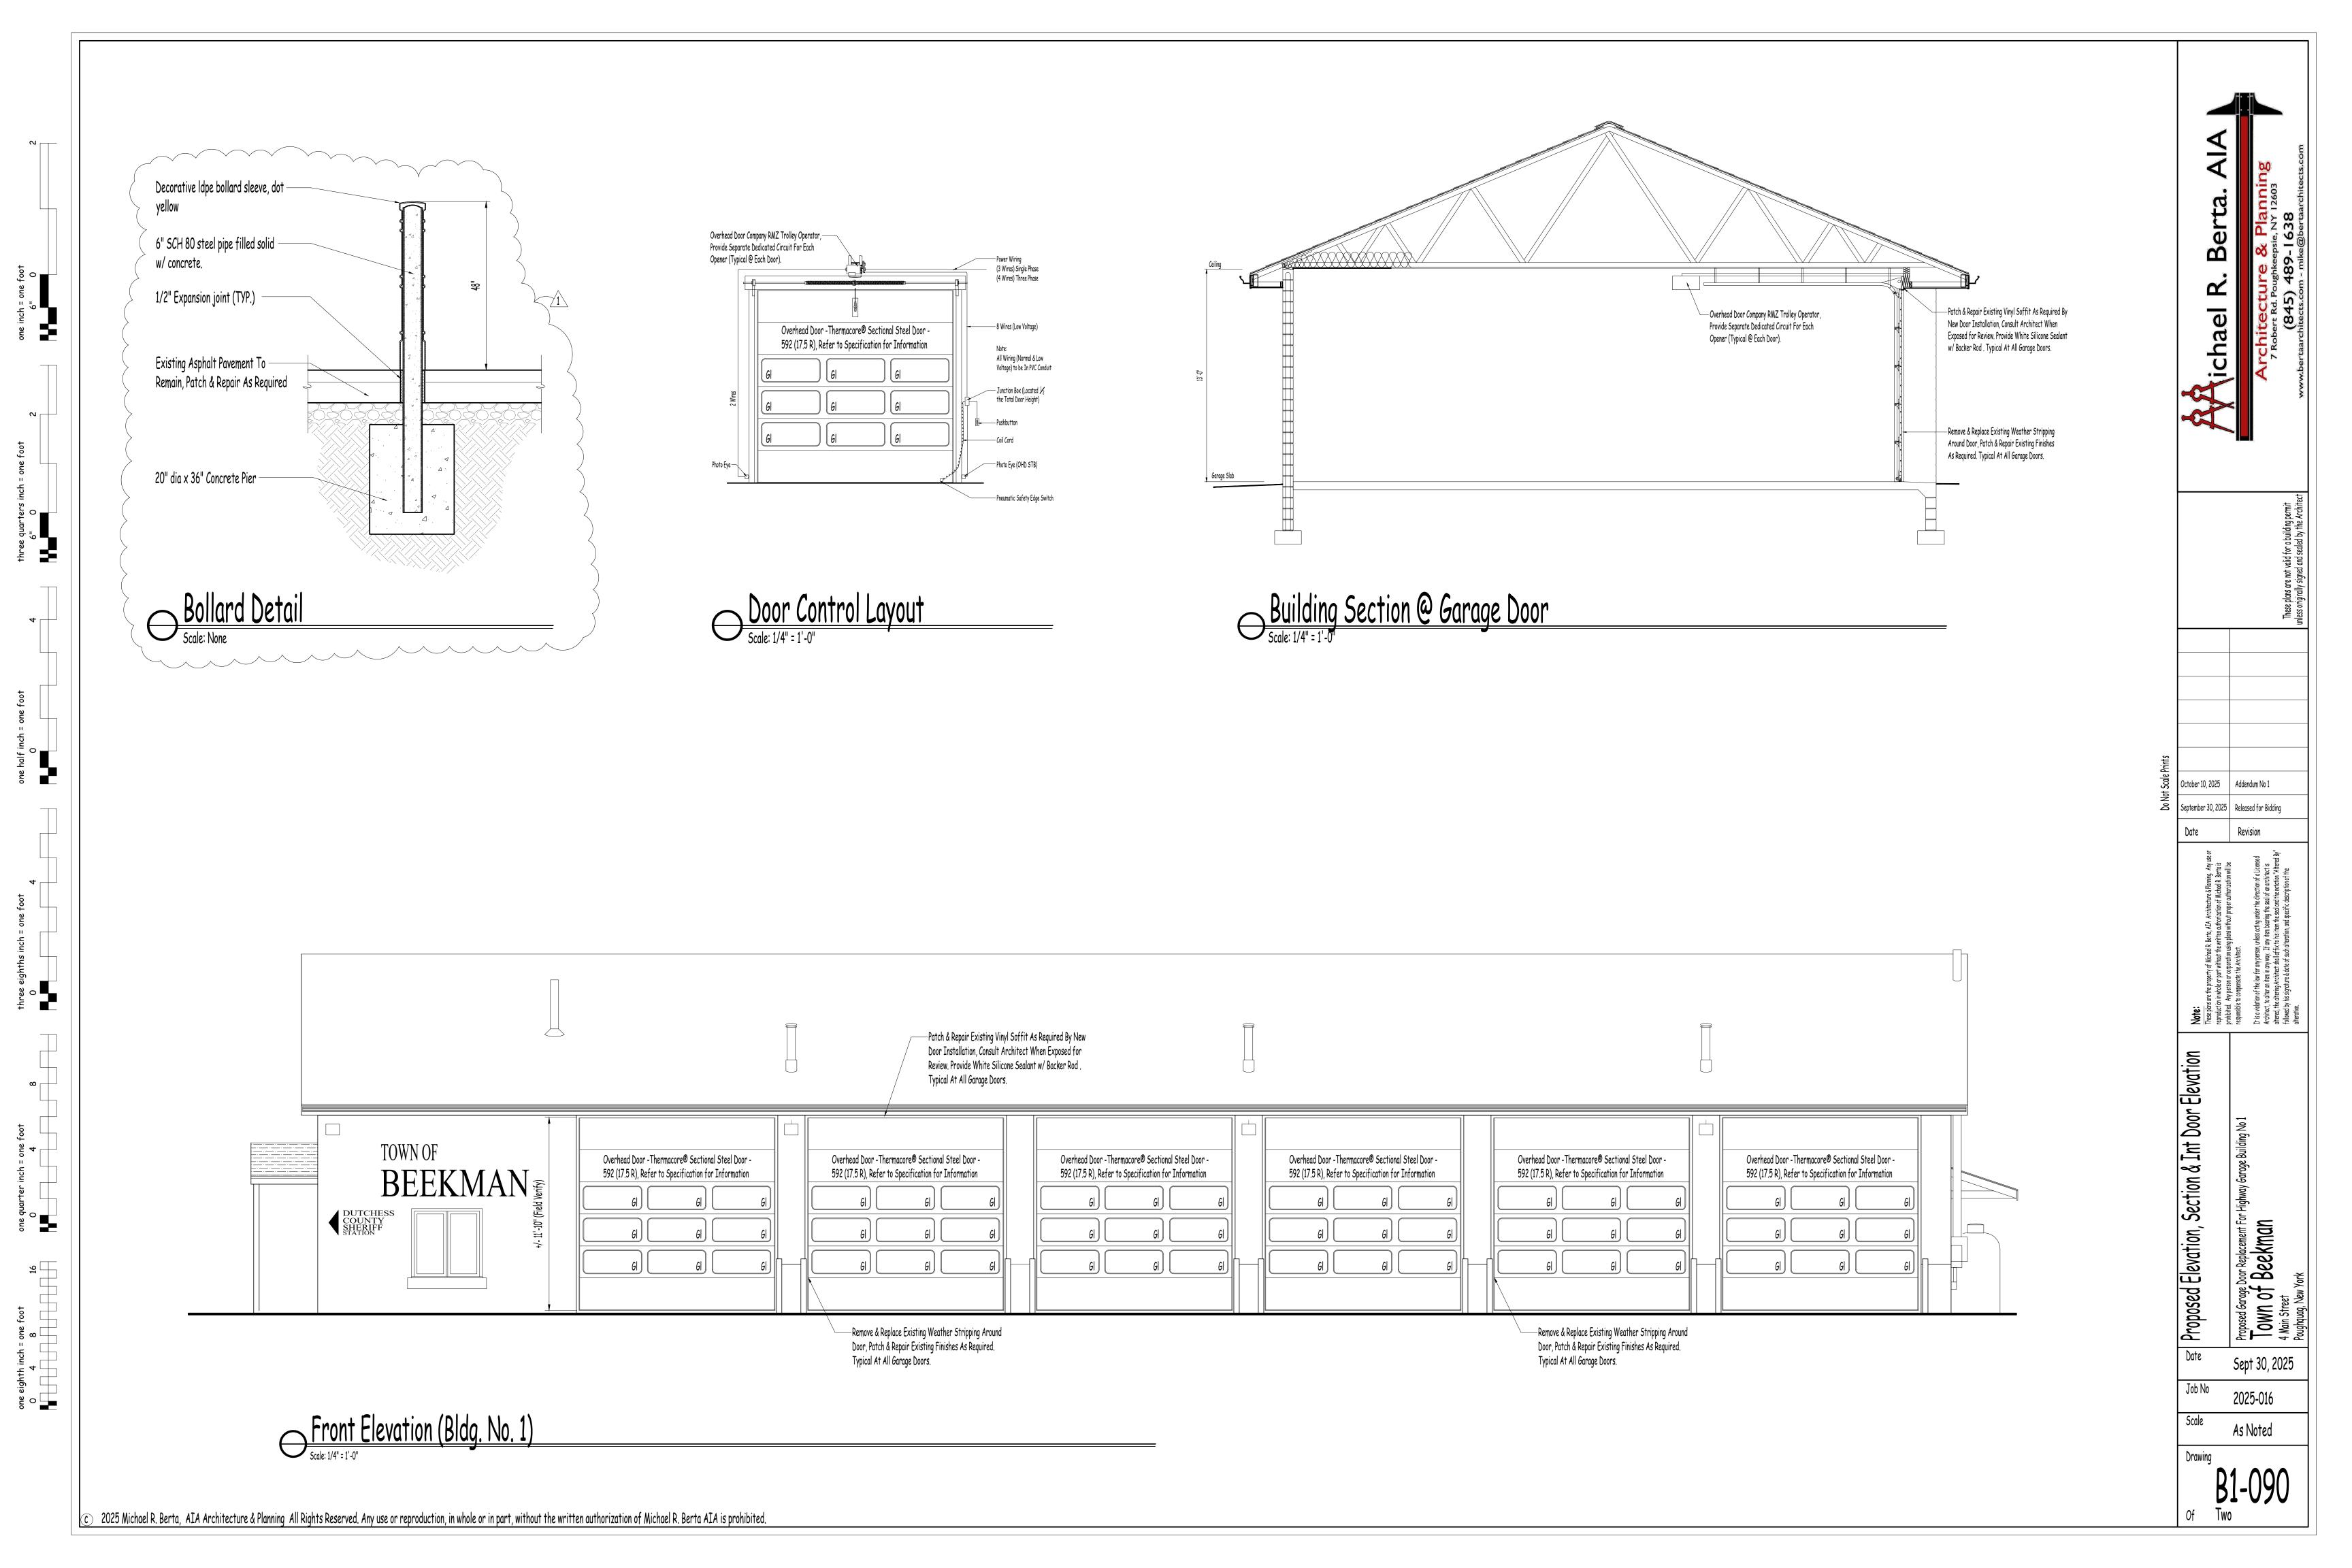

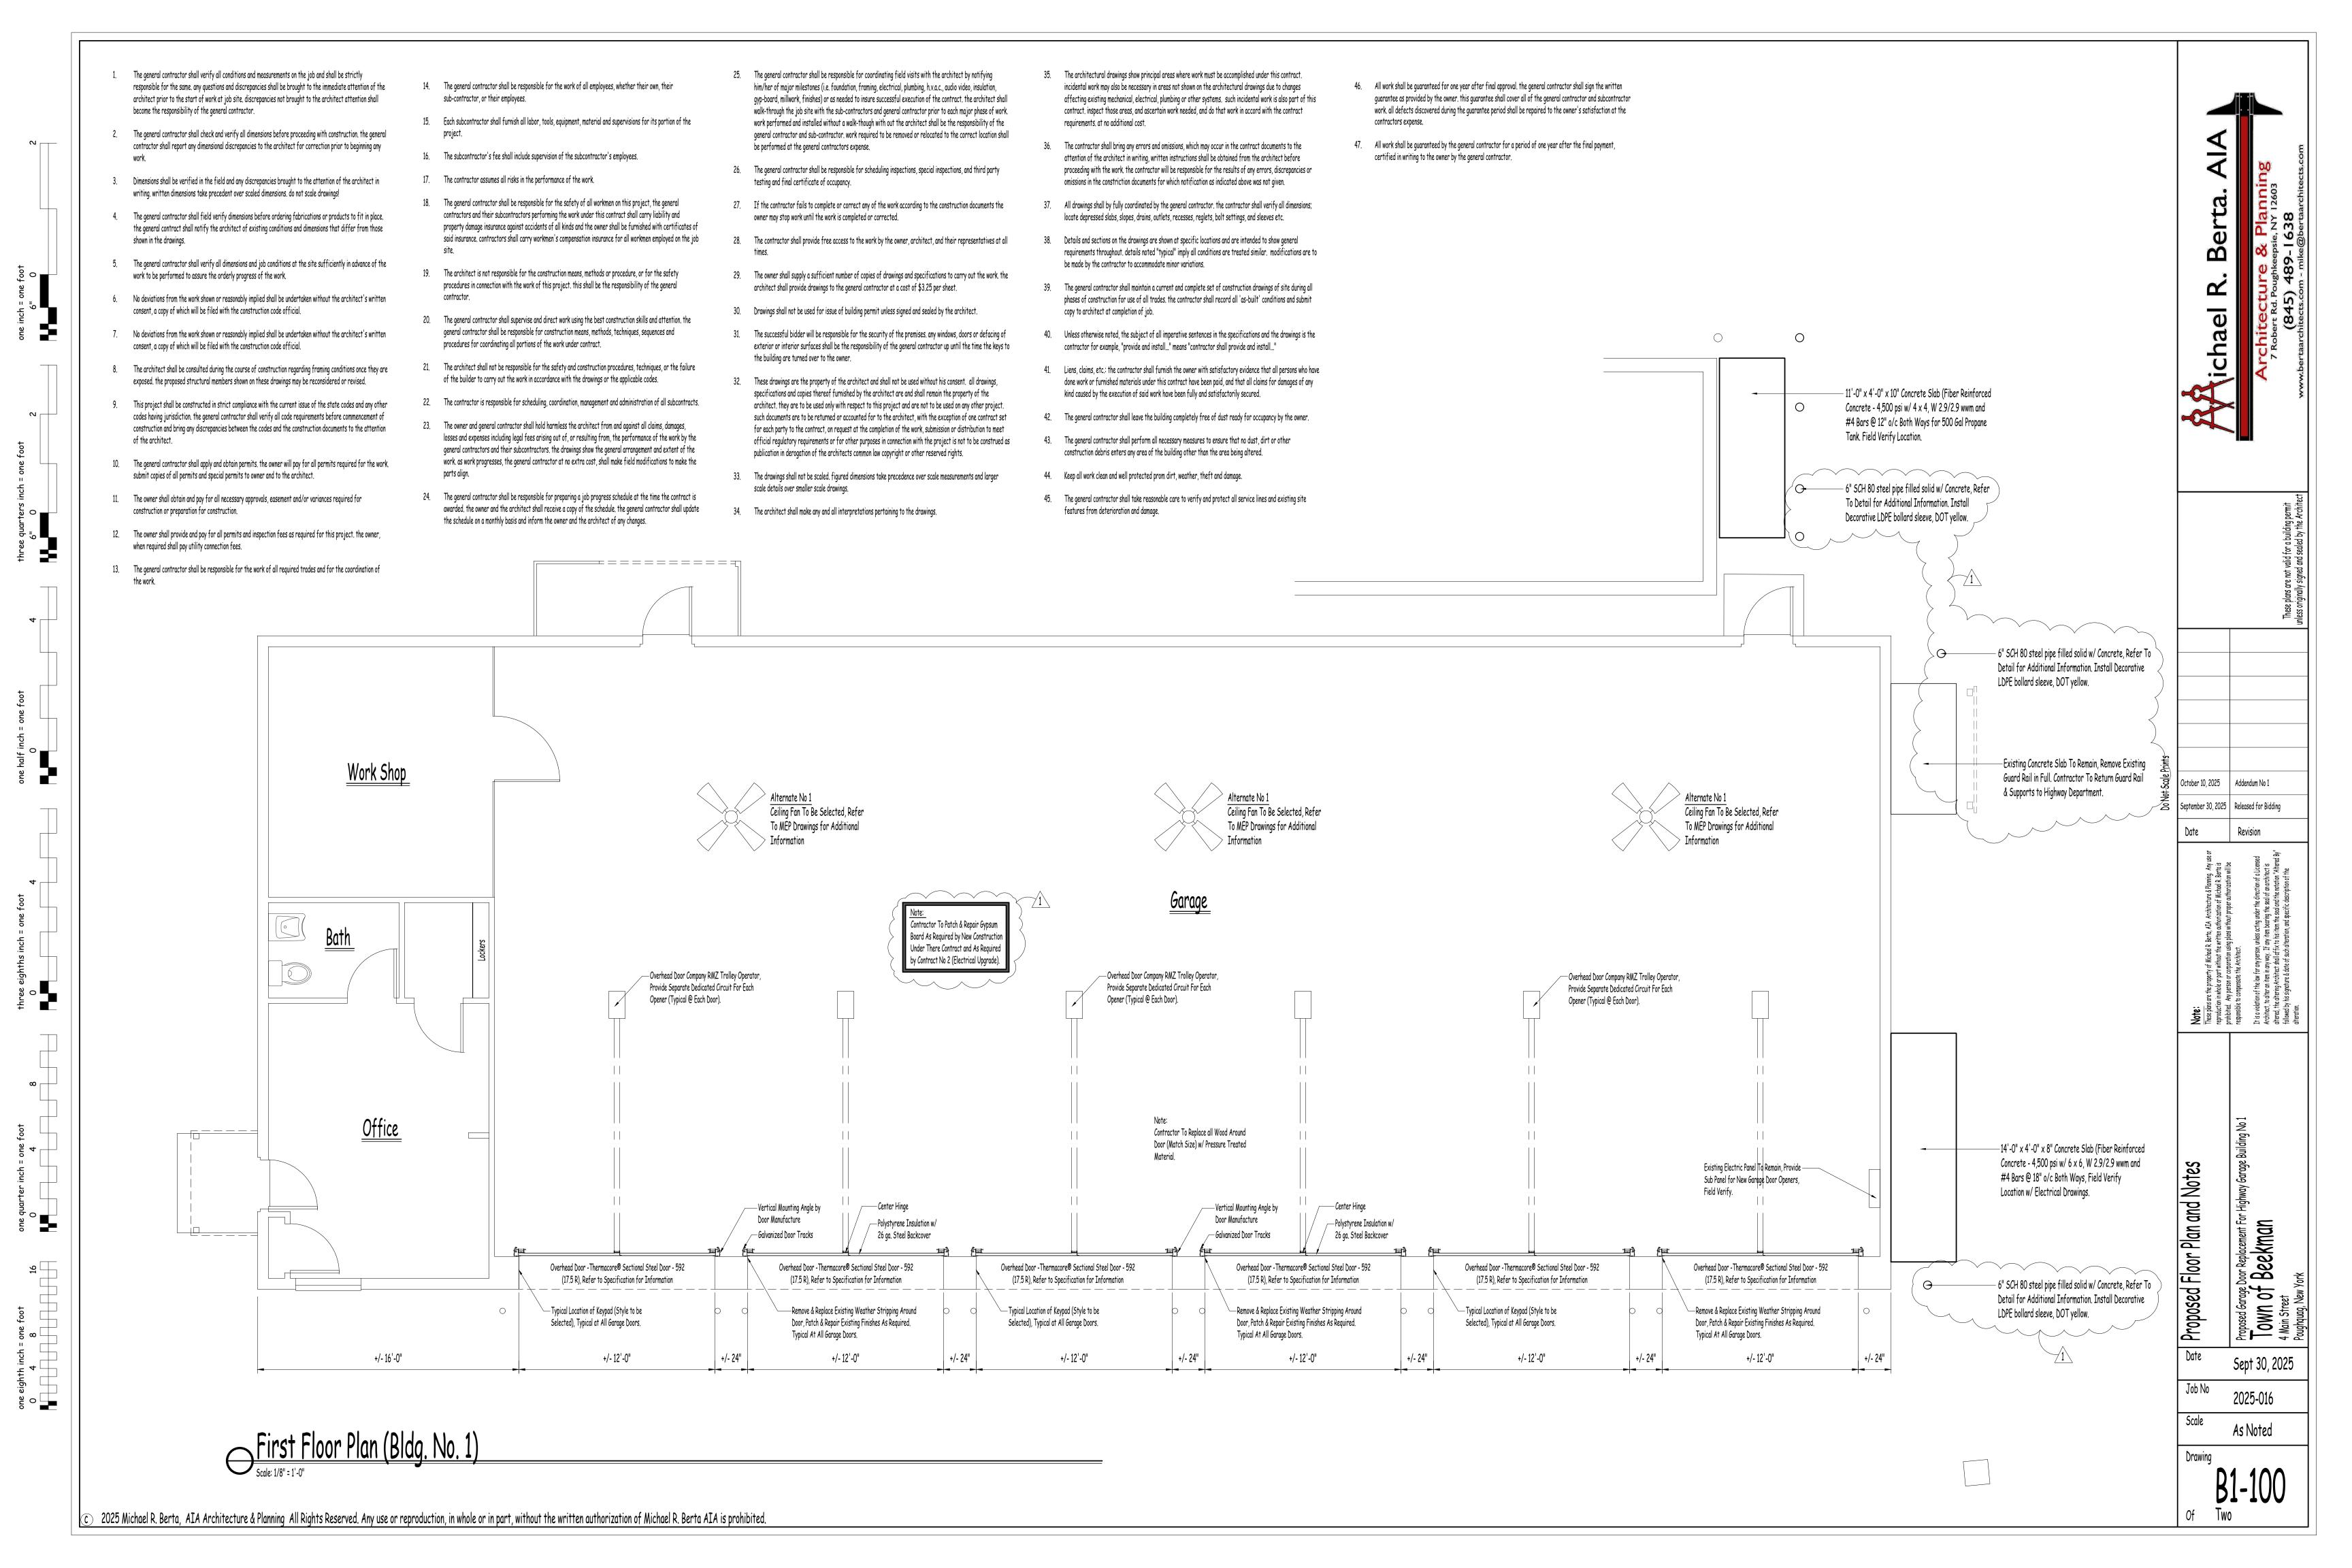

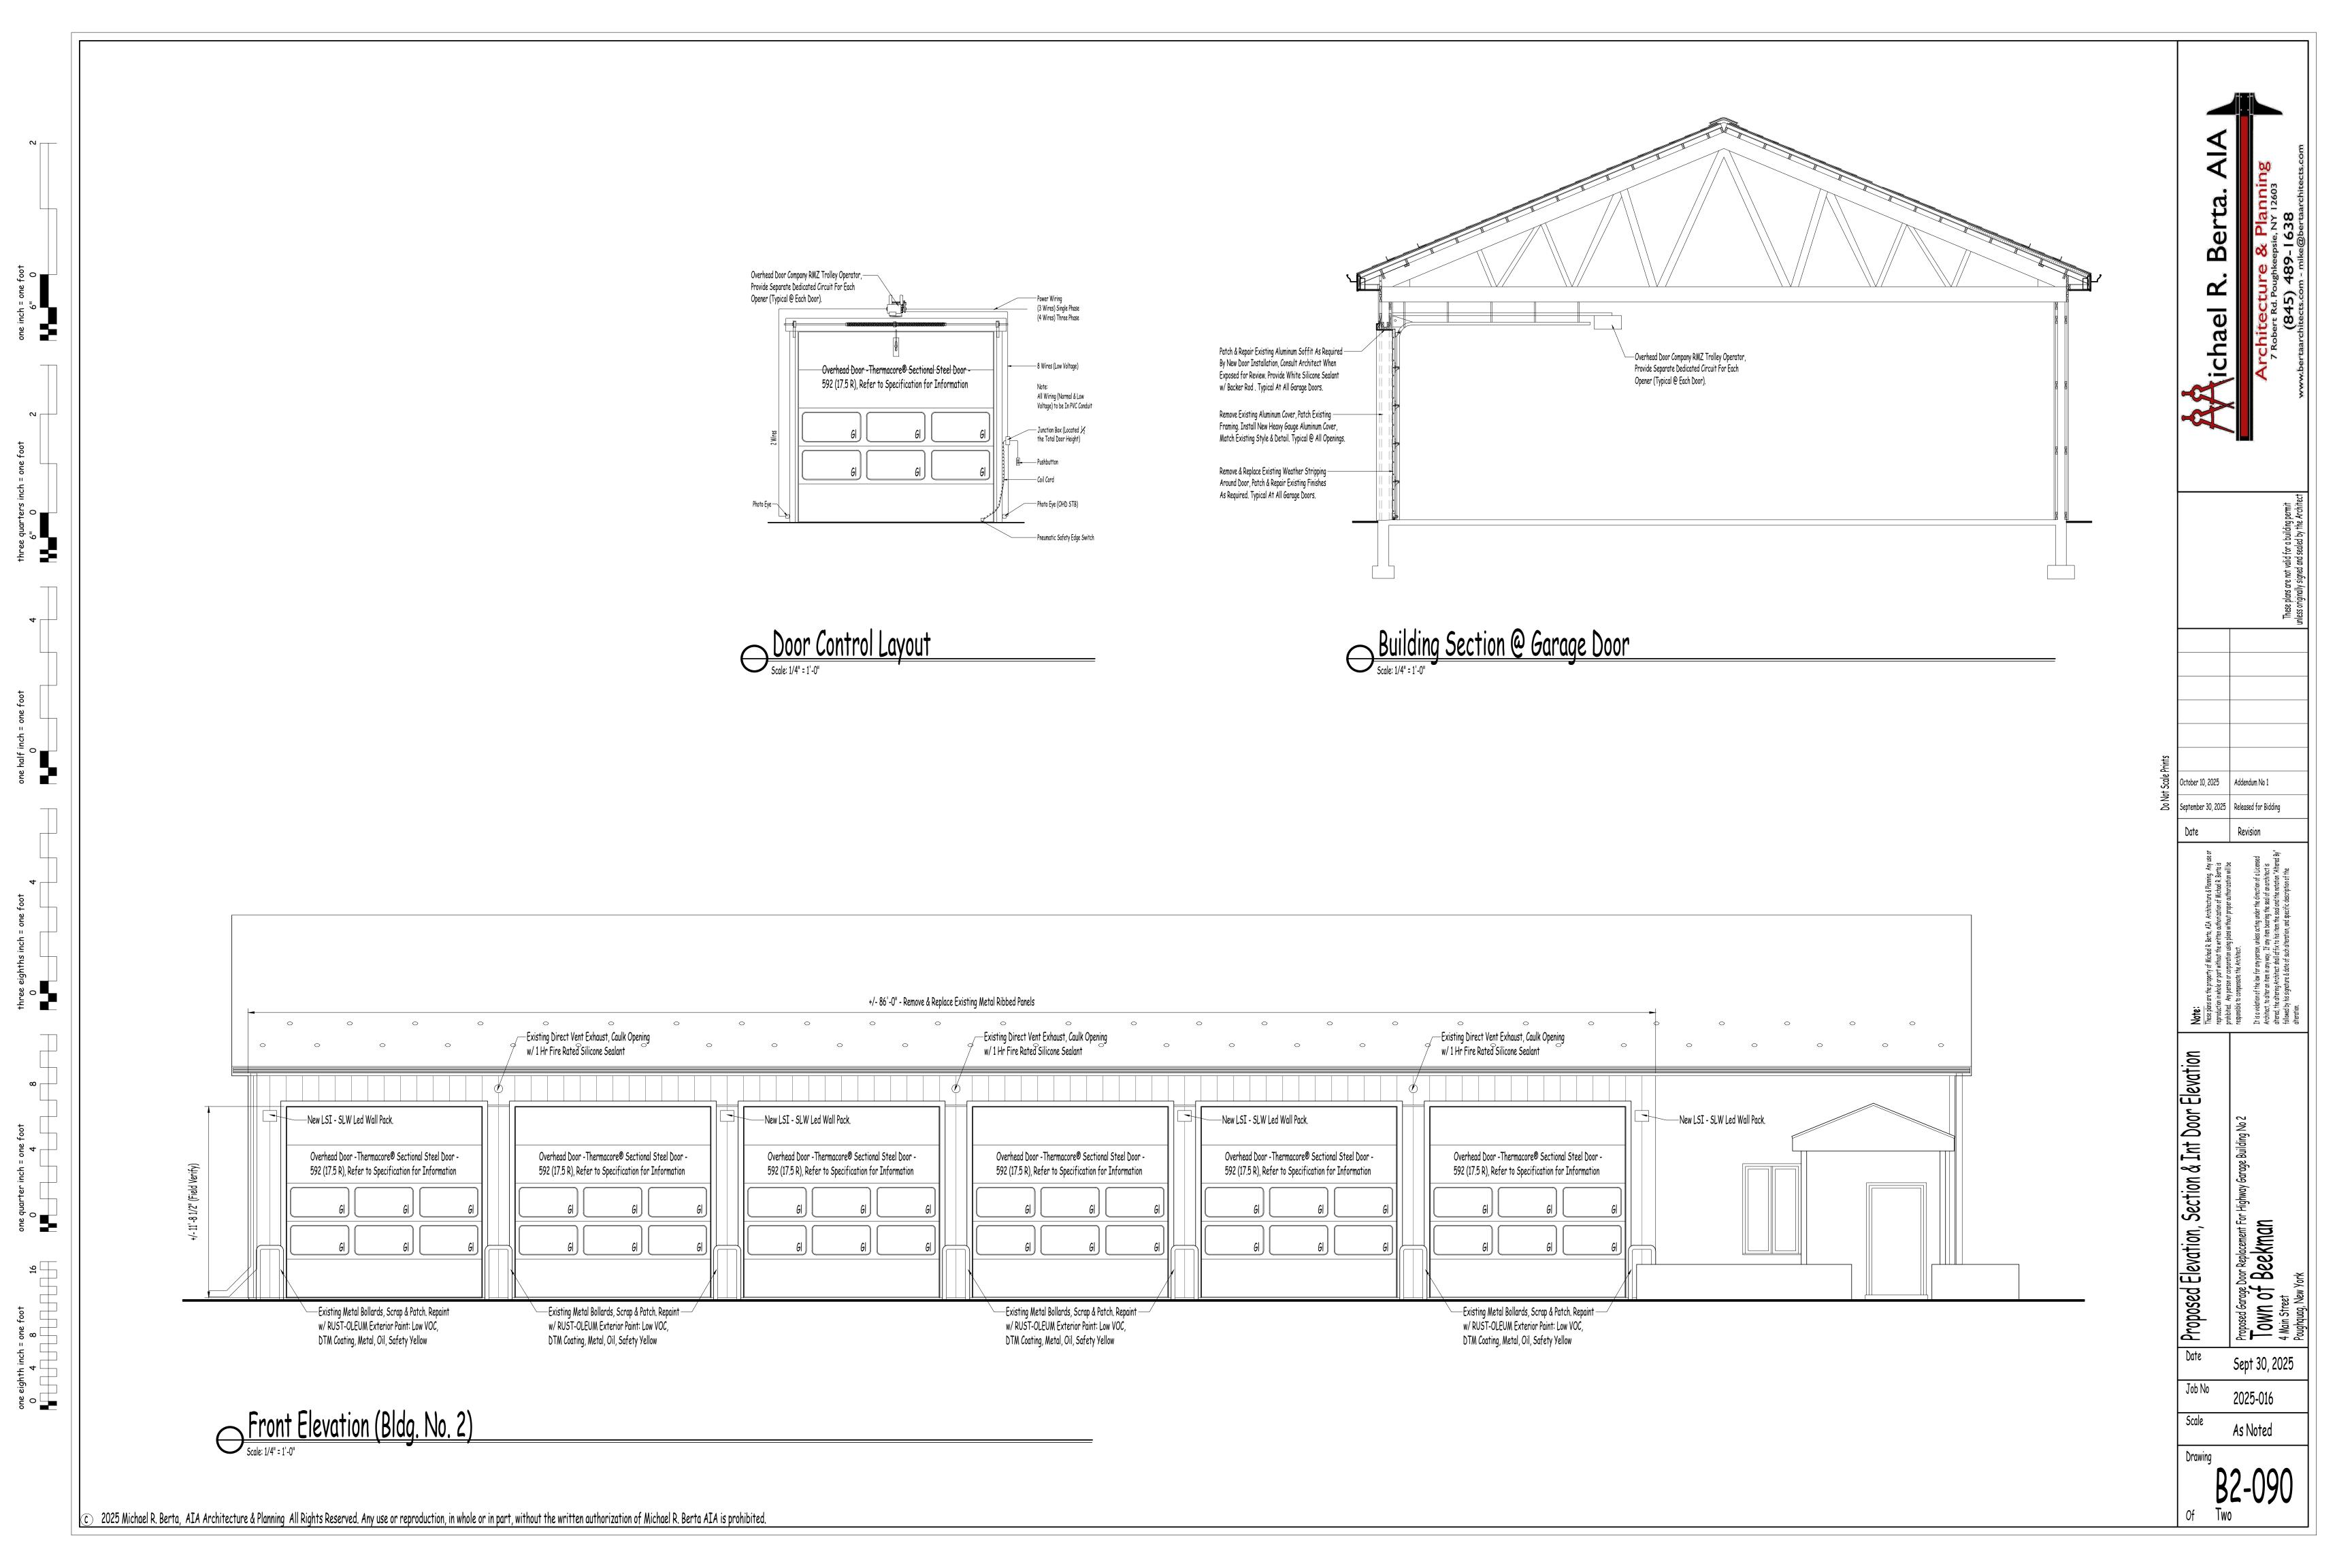

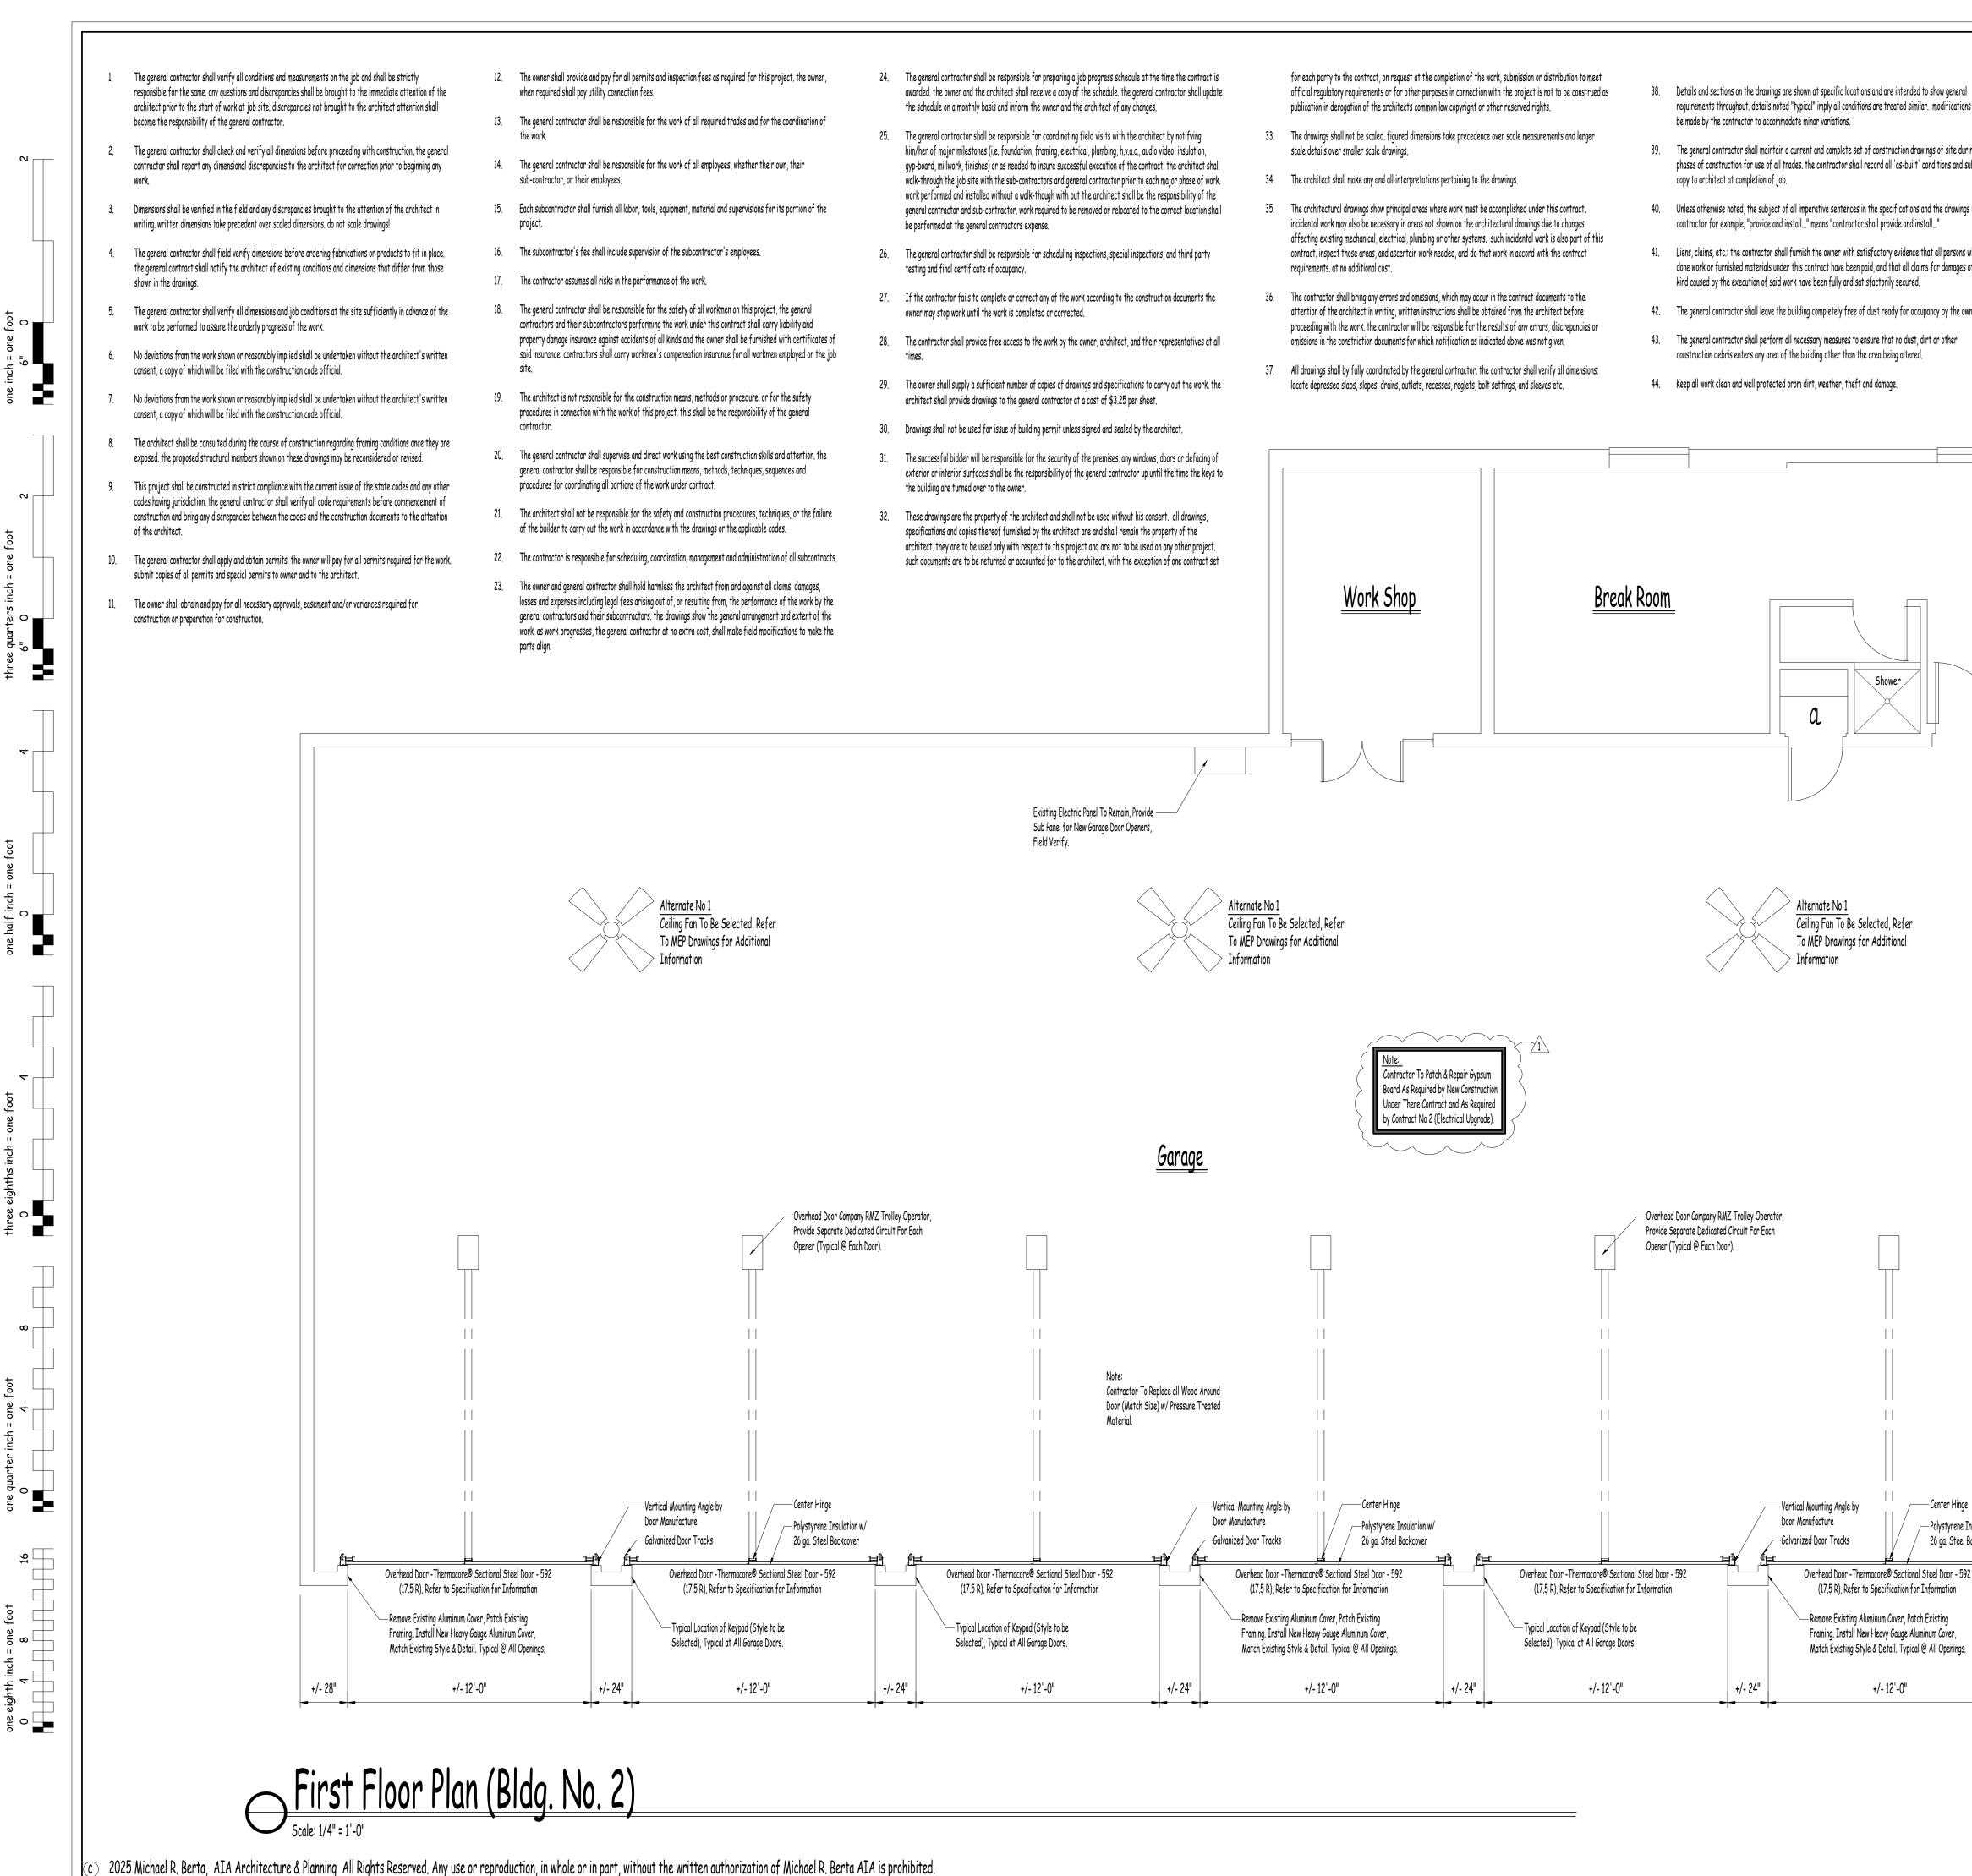

- 38. Details and sections on the drawings are shown at specific locations and are intended to show general requirements throughout, details noted "typical" imply all conditions are treated similar. modifications are to
- 39. The general contractor shall maintain a current and complete set of construction drawings of site during all phases of construction for use of all trades, the contractor shall record all 'as-built' conditions and submit
- 40. Unless otherwise noted, the subject of all imperative sentences in the specifications and the drawings is the
- 41. Liens, claims, etc.: the contractor shall furnish the owner with satisfactory evidence that all persons who have done work or furnished materials under this contract have been paid, and that all claims for damages of any kind caused by the execution of said work have been fully and satisfactorily secured.
- 42. The general contractor shall leave the building completely free of dust ready for occupancy by the owner.
- 43. The general contractor shall perform all necessary measures to ensure that no dust, dirt or other construction debris enters any area of the building other than the area being altered.

45. The general contractor shall take reasonable care to verify and protect all service lines and existing site features from deterioration and damage.

46. All work shall be guaranteed for one year after final approval, the general contractor shall sign the written quarantee as provided by the owner, this quarantee shall cover all of the general contractor and subcontractor work, all defects discovered during the guarantee period shall be repaired to the owner's satisfaction at the

47. All work shall be guaranteed by the general contractor for a period of one year after the final payment, certified in writing to the owner by the general contractor.

Kitchenette

Well Tank

Office

-Polystyrene Insulation w/


26 ga. Steel Backcover

+/- 12'-0"

Men's

<u>Files</u>

Planter

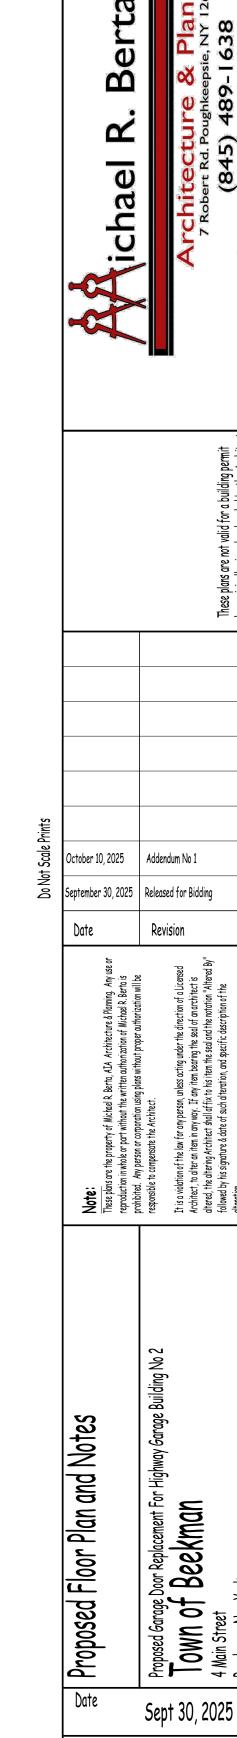

Job No 2025-016

Scale As Noted

Drawing